


NORTH
1" = 40'

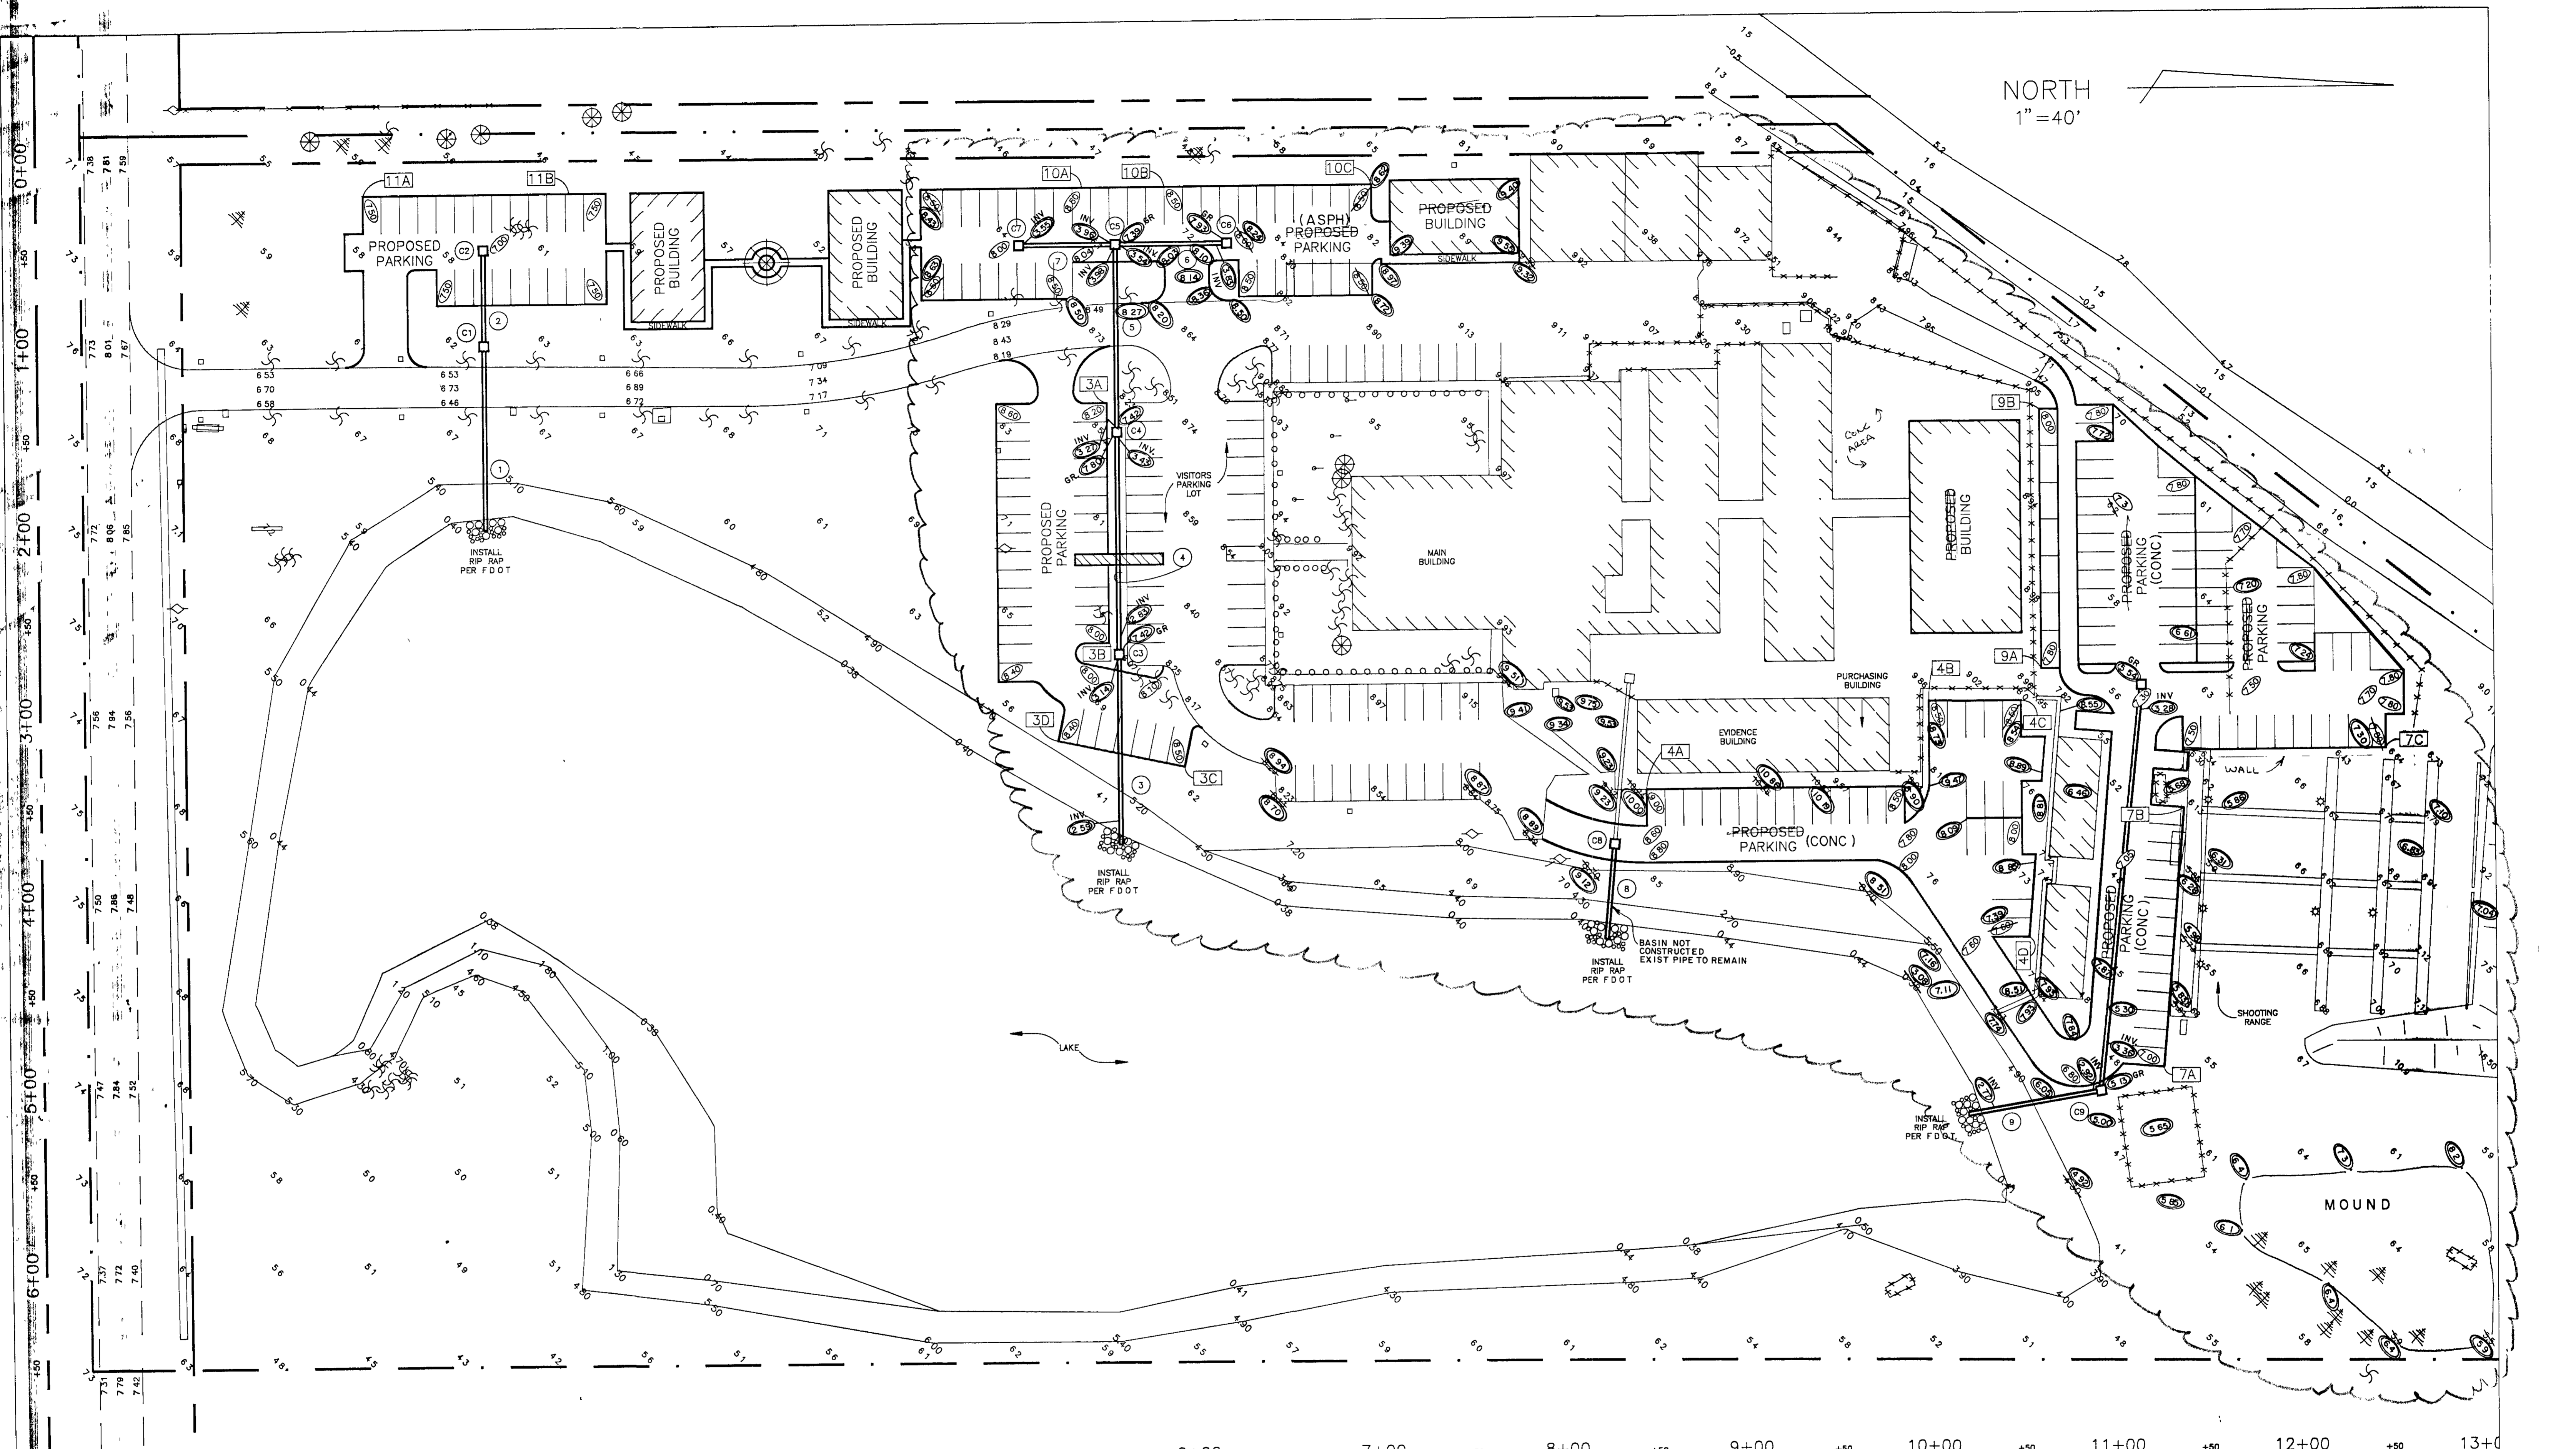

LEGEND

- PROPOSED ROAD
- - - EXISTING ROAD
- x x x x x BARBED WIRE FENCE
- (6.75) AS-BUILT ELEVATIONS
- (7.50) PROPOSED ELEVATIONS

#	PIPE SIZE	LF	INV IN	INV OUT
1	12"x18" RCP	96	3.50	3.00
2	12"x18" RCP	48	5.00	4.00
3	18"x29" R.C.P. CAP	96	3.50	3.00
4	13"x22" R.C.P. CAP	120	4.30	3.50
5	11"x18" R.C.P. CAP	104	5.00	4.30
6	11"x18" R.C.P. CAP	56	3.30	3.30
7	11"x18" R.C.P. CAP	56	3.30	3.00
8	14"x23" R.C.P.	40	4.10	3.60
9	19"x30" R.C.P.	64	4.00	3.60
10	14"x23" R.C.P.	208	5.50	4.00

#	GRATE	N	S	E	W	TYPE
C1	6.00			3.50	4.00	C
C2	7.00			5.00		C
C3	7.50			3.50	3.50	C
C4	7.50			3.50	3.50	C
C5	7.30	4.50	4.50	4.50		D
C6	7.50			3.50		C
C7	8.00			4.10	4.10	C
C8	8.70			4.10	4.10	C
C9	8.80			4.00		D
C10	7.30			5.50		C

7/23/92 ADDED AS-BUILT ELEVATIONS
4/28/92 REVISED SOUTH PKNG LOT
REVISED MARCH 4, 1992

SCALE: 1" = 40'

DES. BY: JD/HS
DRW. BY: HKM
CHK. BY: JD/HS

SURVEYED BY: CARSON/BARR/STANFIELD
APPROVED BY: _____
DATE: JUNE 13, 1991 JDB No: 483040

SHEET 3 OF 7
DRAWING No: 863



AS-BUILT
SHERIFF
DEPARTMENT